


Text in green is to be part of UCSF building database and may be part of UCOP database.

Date: 2020-11-06 UCSF Building Seismic Ratings ACC Tower/Garage, Parnassus Avenue

CAAN# 2408 400 Parnassus Avenue, San Francisco, CA 94131 UCSF Campus Site: Parnassus



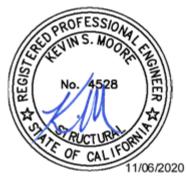

Rating summary	Entry	Notes
UC Seismic Performance Level	V	Findings are based on a drawing review and
(rating)	v	ASCE 41-17 Tier 1 evaluation $1$
Rating basis	Tier 1	ASCE 41-17
Date of rating	2019	
Recommended UCSF priority	Driority	Priority A=Retrofit ASAP
category for retrofit	Priority A	Priority B=Retrofit at next modification permit application
Ballpark total project cost to retrofit to IV rating	Medium (\$50 - \$200/sf)	See recommendations on further evaluation and retrofit
Is 2018-2019 rating required by UCOP?	Yes	Building previously rated IV but does not have a fully documented quantifiable review
Further evaluation recommended?	Tier 3	Advanced analysis will increase the reliability of this assessment

<sup>&</sup>lt;sup>1</sup> The evaluations at UCSF translate the Tier 1 evaluation to a Seismic Performance Level rating using professional judgment discussed among the Seismic Review Committee. Non-compliant items in the Tier 1 evaluation do not automatically put a building into a particular rating category, but such items are evaluated along with the combination of building features and potential deficiencies, focused on the potential for collapse or serious damage to the gravity supporting structure that may threaten occupant safety.



## Building information used in this evaluation

- Structural and Foundation Drawings *Clinics Expansion & Parking Structure,* Reid & Taircs, 43 sheets, dated 4 November 1968.
- Structural Drawings *Elevator Addition*, Degenkolb, 12 sheets, dated 13 August 2001.

# Additional building information known to exist

• *Performance of UCSF Buildings During the October 17, 1989 Loma Prieta Earthquake*, Impell Corporation, dated 17 November 1989.

## Scope for completing this form

Reviewed structural construction drawings and performed an ASCE 41-17 Tier 1 evaluation. Made a brief site visit of building exterior and walked through parking garage levels. Did not evaluate nonstructural life-safety hazards.

## **Brief Description of Structure**

The building comprises over 600,000 sq ft in a six-story parking garage with a ten-story tower above. A steel framed penthouse covering approximately 50% of a typical floor area is located at the roof level. The tower footprint is approximately 150 ft square, with the plaza level changing to a rectangular footprint of approximately 320 ft in the east-west direction and 190 ft in the north-south direction. The tower has a 57 ft square reinforced concrete shear wall core structure as the primary later force resisting system. The plaza level is also the roof level of the garage below, which comprises six levels of parking.

<u>Identification of Levels</u>: The building is sited on a significant slope, with the south side of the building and plaza generally at grade with the northernmost elevation extending down to Level F (approximately six levels below the plaza level), which aligns with grade on the north side of the building. The tower rises ten levels above the plaza level/grade on the south side of the building.

<u>Foundation System</u>: The tower foundation (at the base of the tower within the garage) comprises a reinforced concrete mat that is 13.5 ft thick. The plaza and parking garage building columns and walls, are founded on shallow spread footings. A five-story tall retaining wall, founded on a shallow reinforced concrete strip footing, is located along the south elevation of the parking garage.

Structural System for Vertical (Gravity) Load: The typical tower floor framing comprises steel reinforced concrete pan joists spaced at approximately 3 ft supporting a steel reinforced concrete slab that varies between 3.5 and 6 in. in depth. The joist width varies between 8 and 12 in., and joist depth varies between 19 and 32 in. The joist framing is supported on the steel reinforced concrete core wall in the tower center and steel reinforced concrete beams on steel reinforced columns approximately 30 ft away from the core walls. The typical tower joist floor framing cantilevers between 13 and 18 ft beyond the perimeter column lines. Typical floor framing also includes a post-tensioned concrete girder spanning diagonally from each corner of the concrete core wall to the floor plate perimeter. The minimal floor slabs within the concrete walls and the 24 in. core wall. The concrete core wall continues down through the plaza and parking levels to the foundation below the lowest parking level. The perimeter concrete columns are supported by structural steel plate girders or structural steel columns below the plaza level extending to the foundation below the lowest parking level.

<u>Structural System for Lateral Loads</u>: The lateral load-resisting system of comprises 24 in. thick steel reinforced concrete core walls located in the center of the tower building. Internal concrete walls, 6 and 8-inch-thick, partition the core plan, frame out elevator and stair openings and support stair landings. A





line of circular perimeter columns regularly spaced at approximately 13 ft are interconnected with arched beams ranging in depth from 55 in. at the center to approximately 72 in. at the columns. These frames will participate with the core walls to provide lateral force resistance. Floor diaphragms comprise a steel reinforced concrete slab and joist system. Below the plaza level, a concrete wall on the south side of the building retains earth and provides lateral force resistance. Walls on the west and east sides of the building are similar and provide primary lateral force resistance. Large circular perimeter columns along the North side of the building have arched beams that span between the columns that comprise frames that will participate in lateral load resistance.

## Brief description of seismic deficiencies and Expected Seismic Performance

Identified seismic deficiencies of the building include the following:

- Core walls above the plaza level fail quick checks (maximum shear stress =  $22Vf'_c$  without M<sub>s</sub> System Modification Factor of 4.5). Including M<sub>s</sub> and an allowable shear stress ratio of 2, the maximum DCR is above 2.0 at Levels 1 4 with most stories being greater than 1.0. Certain dimensional peculiarities in the core walls may negatively affect the capacity of the core walls. The core wall heavily-reinforced boundary elements are confined with reinforcing details that do not satisfy current code requirements for special reinforced concrete walls.
- Floors within the concrete core walls contain numerous openings that are unable to transfer internal diaphragm forces to the core walls. The lateral forces generated by slabs and elevator equipment will be transferred to thin (6 to 8 in.) concrete "partition" walls with significant openings; these walls may lose gravity force resistance when subjected to strong shaking.
- The columns around the tower perimeter do not have adequate shear reinforcing to resist internal shear forces that will result from the formation of plastic hinges.
- Half of the columns around the tower perimeter are discontinuous at the plaza level, supported on structural steel plate girders. These structural steel plate girders and their connections have likely not been designed to resist demands associated with this discontinuity.
- Core and perimeter concrete walls below level A fail the quick shear checks for steel reinforced concrete walls (maximum shear stress =  $11vf'_c$  without M<sub>s</sub> System Modification Factor of 4.5). Including M<sub>s</sub> and an allowable shear stress ratio of 2, the DCRs range between 0.9 and 1.3.
- The lateral force resisting system below the plaza level is not balanced, requiring significant load transfer through a thin diaphragm to two three-foot thick walls on the south side of the building. The diaphragm will likely not be able to transfer forces into the walls. Lateral earth pressure associated with the seismic increment at the south wall is also not included in the calculation of the stress DCRs for the below-grade walls.
- The columns on the north side of the garage do not have adequate shear reinforcing to resist the shear forces resulting from plastic hinges forming at the top and bottom of the columns.
- The wall and column arrangement below the plaza likely represent a torsional irregularity that may exacerbate the issues identified above. Columns are short and stiff and may develop high internal shear stresses, resulting in stress cracking and potential reduction in lateral load resistance.

The large number of slab openings within the core and the large openings in the "partition" walls may negatively impact the performance and the gravity-carrying ability of these walls. Inadequately designed steel plate transfer girders and their connections may negatively affect a large portion of the building.

The diaphragms below the plaza may not have adequate capacity to transfer internal shear forces to the reinforced concrete walls. The condition may be exacerbated when lateral earth pressure associated with



the potential seismic increment of six levels of soil is included in the seismic analysis. Perimeter columns at the north side of the garage may also be vulnerable to shear failures.

Structural deficiency	Affects rating?	Structural deficiency	Affects rating?
Lateral system stress check (wall shear, column shear or flexure, or brace axial as applicable)	Y	Openings at shear walls (concrete or masonry)	Y
Load path	Y	Liquefaction	N
Adjacent buildings	N	Slope failure	Ν
Weak story	N	Surface fault rupture	Ν
Soft story	N	Masonry or concrete wall anchorage at flexible diaphragm	N
Geometry (vertical irregularities)	Y	URM wall height-to-thickness ratio	N
Torsion	N	URM parapets or cornices	N
Mass – vertical irregularity	N	URM chimney	Ν
Cripple walls	N	Heavy partitions braced by ceilings	N
Wood sills (bolting)	N	Appendages	N
Diaphragm continuity	Y		

## Summary of review of nonstructural life-safety concerns, including at exit routes.

An assessment of the nonstructural systems has not been performed, but will be performed as part of the Tier 2 evaluation.

UCOP non-structural checklist item	Life safety hazard?	UCOP non-structural checklist item	Life safety hazard?
Heavy ceilings, feature or ornamentation above large lecture halls, auditoriums, lobbies or other areas where large numbers of people congregate	None observed	Unrestrained hazardous materials storage	None observed
Heavy masonry or stone veneer above exit ways and public access areas	None observed	Masonry chimneys	None observed
Unbraced masonry parapets, cornices or other ornamentation above exit ways and public access areas	None observed	Unrestrained natural gas-fueled equipment such as water heaters, boilers, emergency generators, etc.	None observed

### Basis of seismic performance level rating

The building rating of V can be attributed to the identified deficiencies and the potential for increased DCRs related to including seismic increment when evaluating the garage structure.

### **Recommendations for further evaluation or retrofit:**

We recommend that the University perform a more detailed seismic evaluation to determine whether retrofitting is required. We recommend a nonlinear response history analysis (NLRHA) that accounts for the behaviors related to the deficiencies, identifying the potential areas of overstress, including wall, slab, column and beam behavior, joint shear behavior, force transfer at the slab to wall interface below the plaza level and the influence of the retained soil south of the building. NLRHA will provide an opportunity to observe changes in building performance as structural elements yield and internal forces are redistributed to stiffer or stronger elements. This is important for the discontinuous columns at the plaza level. Applicable retrofit measures may include thickening slabs, concrete walls or similar elements to



locally increase strength or balance a potential torsional response. Structural steel plate girders and their connections may require strengthening to resist seismic forces associated with the discontinuous columns at the plaza level.

## Peer review comments on rating

The structural members of the UCSF Seismic Review Committee (SRC) reviewed the evaluation on 25 June 2019 and agree with a rating of V. The SRC agrees that further study, likely a Tier 3 NLRHA, is important for this building.

Additional building data	Entry	Notes
Latitude	37.76407°	
Longitude	-122.4574°	
Are there other structures besides this one under the same CAAN#	No	
Number of stories above lowest perimeter grade	16	
Number of stories (basements) below lowest perimeter grade	0	Site is on a steep slope. South side of garage is six stories below grade on north side
Building occupiable area (OGSF)	621,394	From UCOP spreadsheet
Risk Category per 2016 CBC 1604.5	Ш	Occupant load > 500 and contains educational occupancy above 12th grade.
Building structural height, h <sub>n</sub>	194 ft	As defined per ASCE 7-16 Section 11.2
Coefficient for period, Ct	0.02	ASCE 41-17 equation 4-4 and 7-18
Coefficient for period, 2	0.75	ASCE 41-17 equation 4-4 and 7-18
Estimated fundamental period	1.0 sec	ASCE 41-17 equation 4-4 and 7-18
Site data		
975 yr hazard parameters $S_s$ , $S_1$	1.549g, 0.626g	https://hazards.atcouncil.org/
Site class	D	UCSF Group 2 Buildings, Geotechnical Characteristic and Geohazards (2019)
Site class basis	Estimated	UCSF Group 2 Buildings, Geotechnical Characteristic and Geohazards (2019)
Site parameters $F_a$ , $F_v$	1.0, 1.7	https://hazards.atcouncil.org/ describes *null for F <sub>v</sub> (estimated)
Ground motion parameters $S_{cs}$ , $S_{c1}$	1.537, 1.030	UCSF Group 2 Buildings, Geotechnical Characteristic and Geohazards (2019)
$S_a$ at building period	0.99	Calculated
Site V <sub>s30</sub>	310 m/s	UCSF Group 2 Buildings, Geotechnical Characteristic and Geohazards (2019)
V <sub>s30</sub> basis	Estimated	UCSF Group 2 Buildings, Geotechnical Characteristic and Geohazards (2019)
Liquefaction potential	No	UCSF Group 2 Buildings, Geotechnical Characteristic and Geohazards (2019)

# UCSF



Additional building data	Entry	Notes
Liquefaction assessment basis	Estimated	UCSF Group 2 Buildings, Geotechnical Characteristic and Geohazards (2019)
Landslide potential	No	UCSF Group 2 Buildings, Geotechnical Characteristic and Geohazards (2019)
Landslide assessment basis	Estimated	Rutherford + Chekene Study, 2006
Active fault-rupture hazard identified at site?	No	UCSF Group 2 Buildings, Geotechnical Characteristic and Geohazards (2019)
Site-specific ground motion study?	No	
Applicable code		
Applicable code or approx. date of original construction	Drawings Dated: 1968	Same set of drawings for Tower and Garage
Applicable code for partial retrofit	None	No partial retrofit known
Applicable code for full retrofit	None	No full retrofit known
Model building data		
Model building type North-South	C2 Conc. wall	C1 Conc. Moment frame (potentially)
Model building type East-West	C2 Conc. wall	C1 Conc. Moment frame (potentially)
FEMA P-154 score	N/A	Not included here because we performed ASCE 41 Tier 1 evaluation.
Previous ratings		
Most recent rating	IV	In spreadsheet. Basis for rating is unknown
Date of most recent rating	-	Rating date is unknown
2 <sup>nd</sup> most recent rating	-	
Date of 2 <sup>nd</sup> most recent rating	-	
Appendices		
ASCE 41 Tier 1 checklist included here?	Yes	Refer to attached checklist file






# Appendix A


**Drawing Images** 






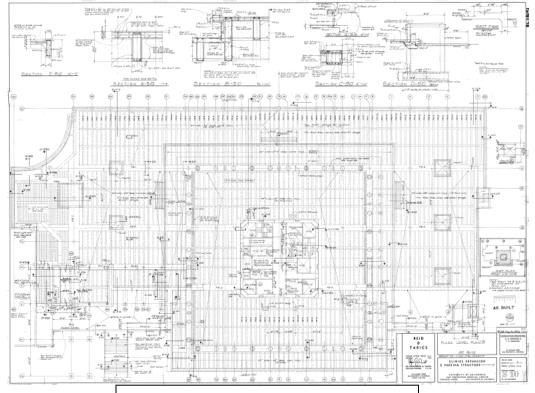



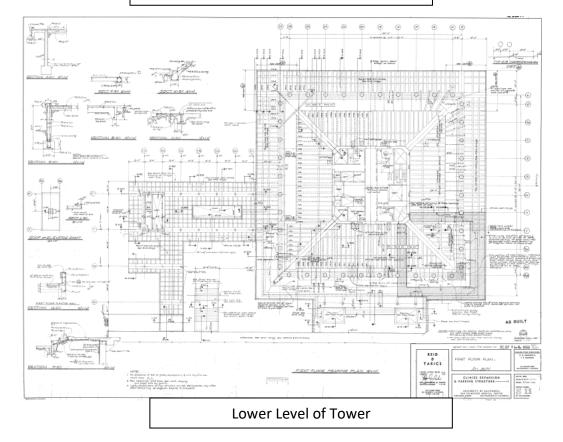



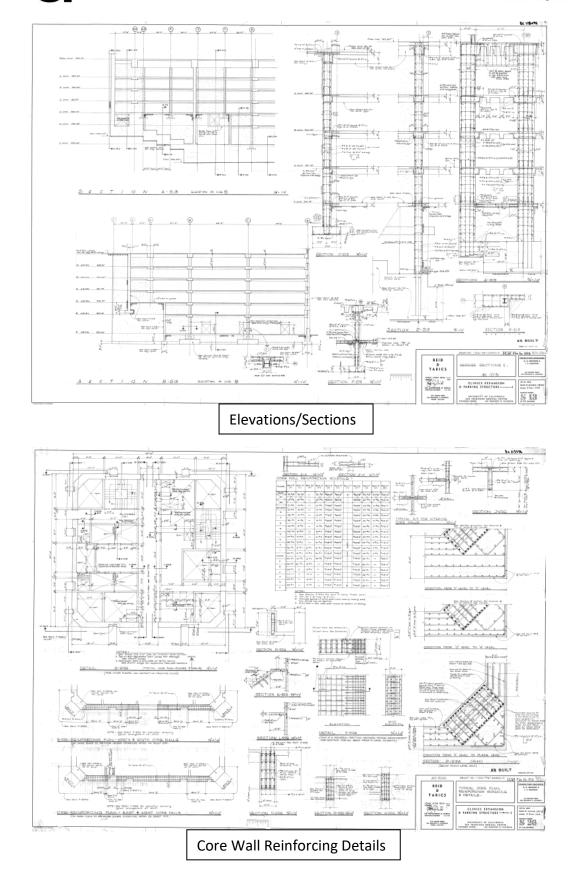

UCS




# UCSF

	Wal	l Elevations	and Frame El	evations	
	.0	$\odot$		cartana 🕤	1
			1		
			1		
			H		1. 
- jac	6'	6	ng fr		
					- 1
	6'				



SIMPSON GUMPERTZ & HEGER

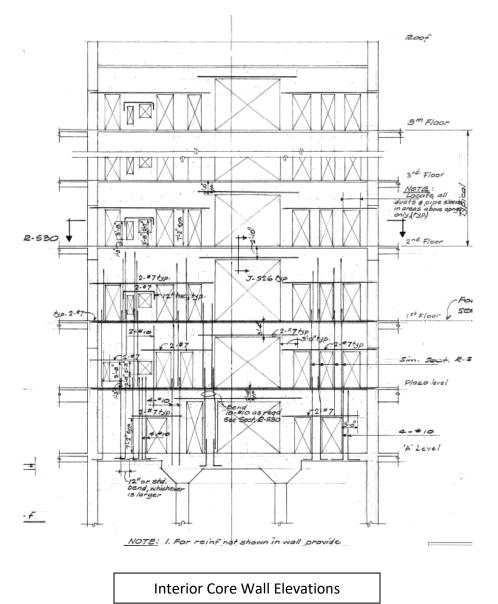





# Appendix B

Checklists

UC Campus: UCSF – Parnassus		Date:		25 June 2019		
Building CAA	N: 2408	Auxiliary CAAN:	By Firm:	Simpso	n Gumpertz	& Heger
Building Nam	e: ACC and ACC	ACC and ACC Garage		KSM	Checked:	KSM
Building Addres	S: 400 Parnassus Avenue, Sar	Francisco, CA 94133	Page:	1	of	3
	ŀ	ASCE 41-17				
	Collapse Prevention Basic Configuration Checklist					
LOW SEISM	LOW SEISMICITY					
BUILDING SYS	STEMS - GENERAL					
		Descr	iption			
C NC N/A U	LOAD PATH: The structure contains a					
$\odot$ $\circ$ $\circ$ $\circ$	serves to transfer the inertial forces as Sec. A.2.1.1. Tier 2: Sec. 5.4.1.1)	sociated with the mass c	of all elements of the	e building to t	ne foundation. (C	ommentary:
	Comments: Some columns are defined.	e discontinuous, b	ut the load path	for all ele	ments is clea	r and well
C NC N/A U	ADJACENT BUILDINGS: The clear dis				-	-
0000	0.25% of the height of the shorter bu (Commentary: Sec. A.2.1.2. Tier 2: Se			e seismicity,		in Seismicity.
	Comments: The garage is integrated with Millberry Garage; this condition is not a deficiency					
C NC N/A U	MEZZANINES: Interior mezzanine levels are braced independently from the main structure or are anchored to the seismic- force-resisting elements of the main structure. (Commentary: Sec. A.2.1.3. Tier 2: Sec. 5.4.1.3)					
	Comments: The building does	not have mezzani	ne levels.			
BUILDING SYS	STEMS - BUILDING CON	FIGURATION				
		Descr	iption			
C NC N/A U	WEAK STORY: The sum of the shear	strengths of the seism	ic-force-resisting sy	/stem in any	story in each dir	ection is not
$\odot$ $\circ$ $\circ$ $\circ$ $\circ$	less than 80% of the strength in the ac	ljacent story above. (Co	ommentary: Sec. A2	2.2.2. Tier 2:	Sec. 5.4.2.1)	
	Comments: No weak stories ex systems and elements.	kist in the building	as each floor h	as similar	seismic force	eresisting
C NC N/A U	SOFT STORY: The stiffness of the se	iomic force registing a	votom in onvotonvi	a not loop th	an 70% of the a	niamia forco
0000	resisting system stiffness in an adjacer of the three stories above. (Commenta	t story above or less that	in 80% of the average			
	Comments: The building does softer stories of the tower loca				r up the build	ding, with
C NC N/A U	VERTICAL IRREGULARITIES: All ver (Commentary: Sec. A.2.2.4. Tier 2: Se		smic-force-resisting	g system are	continuous to the	e foundation.
	Comments: Perimeter columi further study.	ns are supported c	on steel plate g	irders. Th	is irregularity	/ requires

UC Campus:	UCSF – Parn	UCSF – Parnassus		25 June 2019		
Building CAAN:	2408	Auxiliary CAAN:	By Firm:	Simpson Gumpertz 8		& Heger
Building Name:	Building Name: ACC and ACC Garage			KSM	Checked:	KSM
Building Address:	400 Parnassus Avenue, San	Francisco, CA 94133	Page:	2	of	3
ASCE 41-17         Collapse Prevention Basic Configuration Checklist         C       N/A       U       GEOMETRY: There are no changes in the net horizontal dimension of the seismic-force-resisting system of more than 30% in a story relative to adjacent stories, excluding one-story penthouses and mezzanines. (Commentary: Sec. A.2.2.5. Tier 2: Sec. 5.4.2.4)         C       N/A       U       Geoments: Seismic force resisting system is regular and consistent at each level.         C       NC       N/A       U       MASS: There is no change in effective mass of more than 50% from one story to the next. Light roofs, penthouses, and						
• • • • • • • • • • • • • • • • • • •	Comments: Effective mass is considered. (Comments: Effective mass is considered.) ORSION: The estimated distance bethe building width in either plan dimens	Commentary: Sec. A.2.2.6.	Tier 2: Sec. 5.4	4.2.5) <b>iilding.</b>		

# MODERATE SEISMICITY (COMPLETE THE FOLLOWING ITEMS IN ADDITION TO THE ITEMS FOR LOW SEISMICITY)

# GEOLOGIC SITE HAZARD

				Description
С	NC	N/A	U	LIQUEFACTION: Liquefaction-susceptible, saturated, loose granular soils that could jeopardize the building's seismic
-	$\odot$	$\cap$	$\cap$	performance do not exist in the foundation soils at depths within 50 ft (15.2m) under the building. (Commentary: Sec. A.6.1.1.
~	0	0	<b>S</b>	Tier 2: 5.4.3.1)
				Comments: Indicated as moderate, but likely very low based on input from John Egan
				comments. Indicated as moderate, but intery very low based on input nom commentation
_				
С	NC	N/A	U	SLOPE FAILURE: The building site is located away from potential earthquake-induced slope failures or rockfalls so that it
			0	is unaffected by such failures or is capable of accommodating any predicted movements without failure. (Commentary:
	-2-	-2-		Sec. A.6.1.2. Tier 2: 5.4.3.1)
				Comments: Low probability based on work by Butherford . Chekene
				Comments: Low probability based on work by Rutherford + Chekene
~	NO	NI/A		
C	NC	N/A	U	SURFACE FAULT RUPTURE: Surface fault rupture and surface displacement at the building site are not anticipated.
• 💿	0	0	0	(Commentary: Sec. A.6.1.3. Tier 2: 5.4.3.1)
		~~		
				Comments: No potential for surface fault rupture

UC Campu	S: UCSF – Parr	nassus	Date:		25 June 2019	
Building CAAI	N: 2408	Auxiliary CAAN:	By Firm:	Simpson Gumpertz & Hege		& Heger
Building Nam	e: ACC and ACC	ACC and ACC Garage		KSM	Checked:	KSM
Building Addres	S: 400 Parnassus Avenue, Sar	n Francisco, CA 94133	Page:	3	of	3
HIGH SEISM	Collapse Prevention					O THE
	MODERATE SEISMIC	511 Y)				
		Descripti	on			
CNCN/AU ⊙CCC	OVERTURNING: The ratio of the leas the building height (base/height) is gre Comments: The garage is sig special consideration of integ	eater than 0.6 <i>Sa</i> . (Commentation) Inificantly wider than	ary: Sec. A.6.2. <b>necessary t</b>	1. Tier 2: Se	c. 5.4.3.3)	
C NC N/A U	TIES BETWEEN FOUNDATION ELE piles, and piers are not restrained by b Tier 2: Sec. 5.4.3.4) Comments: Foundation elem concrete slab.	beams, slabs, or soils classi	ied as Site Clas	ss A, B, or C	. (Commentary: S	Sec. A.6.2.2.

UC Campus:	UCSF	Date:	25 June 2019			
Building CAAN:	2408	Auxiliary CAAN:	By Firm:	Simpson Gumpertz & Hege		
Building Name:	ACC and	Initials:	KDP	Checked:	KSM	
Building Address:	400 Parnassus Avenue	Page:	1	of	3	
ASCE 41-17						

# **Collapse Prevention Structural Checklist For Building Type C2-C2A**

Lo	w ar	nd M	ode	erate Seismicity
Se	ismi	c-Fo	orce	-Resisting System
				Description
		N/A		COMPLETE FRAMES: Steel or concrete frames classified as secondary components form a complete vertical-load-carrying system. (Commentary: Sec. A.3.1.6.1. Tier 2: Sec. 5.5.2.5.1)
				Comments: Concrete pan joists support a concrete slab. Joists span to core walls and beams and columns at the building exterior. Perimeter concrete columns land on deep steel plate girder transfer beams or steel columns extending through the parking garage.
	NC	N/A	U	REDUNDANCY: The number of lines of shear walls in each principal direction is greater than or equal to 2. (Commentary: Sec. A.3.2.1.1. Tier 2: Sec. 5.5.1.1)
				Comments: The central core is a rectangular tube wall structure. Exterior columns will participate in the lateral load resistance for the building, but are not relied upon in the Tier 1.
C	-	N/A	U	SHEAR STRESS CHECK: The shear stress in the concrete shear walls, calculated using the Quick Check procedure of Section 4.4.3.3, is less than the greater of 100 lb/in. <sup>2</sup> (0.69 MPa) or $2\sqrt{f_c}$ . (Commentary: Sec. A.3.2.2.1. Tier 2: Sec. 5.5.3.1.1)
				Comments: The lower six stories exceed the shear stress check. Certain details in the walls require further evaluation to ensure adequate capacity. Core and perimeter concrete walls below Level A also fail the quick stress check (without considering soil loading).
	NC	N/A	U	REINFORCING STEEL: The ratio of reinforcing steel area to gross concrete area is not less than 0.0012 in the vertical direction and 0.0020 in the horizontal direction. (Commentary: Sec. A.3.2.2.2. Tier 2: Sec. 5.5.3.1.3)
				Comments: Wall steel exceeds minimum ratios.
Со	nne	ctio	าร	
				Description
C C	_	N/A ⓒ		WALL ANCHORAGE AT FLEXIBLE DIAPHRAGMS: Exterior concrete or masonry walls that are dependent on flexible diaphragms for lateral support are anchored for out-of-plane forces at each diaphragm level with steel anchors, reinforcing dowels, or straps that are developed into the diaphragm. Connections have strength to resist the connection force calculated in the Quick Check procedure of Section 4.4.3.7. (Commentary: Sec. A.5.1.1. Tier 2: Sec. 5.7.1.1)
				Comments: not applicable to this building
С	NC	N/A	U	TRANSFER TO SHEAR WALLS: Diaphragms are connected for transfer of seismic forces to the shear walls. (Commentary:

the core wall) are not adequately tied to core walls (excessive openings).

Comments: Larger diaphragm to core wall connection is adequate. Interior diaphragms (within

Sec. A.5.2.1. Tier 2: Sec. 5.7.2)

 $\odot \circ \circ \circ$ 

UC Campus:	UCSF - Parnassus		Date:	25 June 2019		
Building CAAN:	2408 Auxiliary CAAN:		By Firm:	Simpson Gumpertz & Hege		& Heger
Building Name:	ACC and ACC Garage		Initials:	KDP	Checked:	KSM
Building Address:	400 Parnassus Avenue, San Francisco, CA 94133		Page:	2	of	3
ASCE 41-17 Collapse Prevention Structural Checklist For Building Type C2-C2A						


C NC N/A	-	FOUNDATION DOWELS: Wall reinforcement is doweled into the foundation with vertical bars equal in size and spacing to the vertical wall reinforcing directly above the foundation. (Commentary: Sec. A.5.3.5. Tier 2: Sec. 5.7.3.4)		
		Comments: Wall steel is doweled into the foundation (wall bars extend into foundation elements)		

# High Seismicity (Complete the Following Items in Addition To The Items For Low And Moderate Seismicity)

# Seismic-Force-Resisting System

				Description
c O	NC ⓒ	N/A	U	DEFLECTION COMPATIBILITY: Secondary components have the shear capacity to develop the flexural strength of the components. (Commentary: Sec. A.3.1.6.2. Tier 2: Sec. 5.5.2.5.2)
				Comments: The tower perimeter moment frame columns, if considered secondary components, do not have adequate shear reinforcing to develop column flexural strength.
C C	NC C	N/A ⓒ	_	FLAT SLABS: Flat slabs or plates not part of the seismic-force-resisting system have continuous bottom steel through the column joints. (Commentary: Sec. A.3.1.6.3. Tier 2: Sec. 5.5.2.5.3)
				Comments: no flat slabs in the building
C C	NC C	N/A ⓒ	_	COUPLING BEAMS: The ends of both walls to which the coupling beam is attached are supported at each end to resist vertical loads caused by overturning. (Commentary: Sec. A.3.2.2.3. Tier 2: Sec. 5.5.3.2.1)
				Comments: no coupling beams in the building

# Diaphragms (Stiff or Flexible)

	Description	
C NC N/A U C C C C	DIAPHRAGM CONTINUITY: The diaphragms are not composed of split-level floors and do not have expansion joints. (Commentary: Sec. A.4.1.1. Tier 2: Sec. 5.6.1.1)	
	Comments: Diaphragms are generally continuous, without joints.	
C NC N/A U C C C C	PENINGS AT SHEAR WALLS: Diaphragm openings immediately adjacent to the shear walls are less than 25% of the all length. (Commentary: Sec. A.4.1.4. Tier 2: Sec. 5.6.1.3)	
	Comments: Larger diaphragm conditions are adequate. Interior diaphragms (within the core wall) have very large openings.	

UC Campus:	UCSF - Parnassus		Date:	25 June 2019		
Building CAAN:	2408 Auxiliary CAAN:		By Firm:	Simpson Gumpertz & Heger		
Building Name:	ACC and ACC Garage		Initials:	KDP	Checked:	KSM
Building Address:	400 Parnassus Avenue, San Francisco, CA 94133		Page:	3	of	3

# ASCE 41-17

# **Collapse Prevention Structural Checklist For Building Type C2-C2A**

			Description
C NC	C N/	A U	CROSS TIES: There are continuous cross ties between diaphragm chords. (Commentary: Sec. A.4.1.2. Tier 2: Sec. 5.6.1.2)
00	•	0	Comments: not applicable to this building
			STRAIGHT SHEATHING: All straight-sheathed diaphragms have aspect ratios less than 2-to-1 in the direction being considered. (Commentary: Sec. A.4.2.1. Tier 2: Sec. 5.6.2)
			Comments: not applicable to this building
		-	SPANS: All wood diaphragms with spans greater than 24 ft (7.3 m) consist of wood structural panels or diagonal sheathing (Commentary: Sec. A.4.2.2. Tier 2: Sec. 5.6.2)
			Comments: not applicable to this building
C NC	: N/	A U	DIAGONALLY SHEATHED AND UNBLOCKED DIAPHRAGMS: All diagonally sheathed or unblocked wood structural pane
0.0	•	0	diaphragms have horizontal spans less than 40 ft (12.2 m) and aspect ratios less than or equal to 4-to-1. (Commentary Sec. A.4.2.3. Tier 2: Sec. 5.6.2)
			Comments: not applicable to this building
		-	OTHER DIAPHRAGMS: Diaphragms do not consist of a system other than wood, metal deck, concrete, or horizonta bracing. (Commentary: Sec. A.4.7.1. Tier 2: Sec. 5.6.5)
			Comments: Diaphragms are all reinforced concrete
Conne	ecti	ons	
			Description
			UPLIFT AT PILE CAPS: Pile caps have top reinforcement, and piles are anchored to the pile caps. (Commentary: Sec. A.5.3.8. Tier 2: Sec. 5.7.3.5)
- <u>-</u> <u>-</u> -	-0		Comments: This building does not have pile caps.





# Appendix C

**Tier 1 Calculations** 

SIMPSON GUN	
	Engineering of Structures and Building Enclosures
CLIENT UCSF	


SHEET NO.	1
PROJECT NO.	197042.00
DATE	11/04/2020
BY	KDP
CHECKED	KSM

SUBJECT Tier 1 - Quick Checks - ACC Garage

# Hazard Level BSE-2E

$MCE_{R}$ ground motion (period=0.2s)	SS	1.535 g
MCE <sub>R</sub> ground motion (period=1.0s)	S <sub>1</sub>	0.605 g
Site amplification factor at 0.2s	$F_{\alpha}$	1.0
Site amplification factor at 1.0s	$F_v$	1.7
Site modified spectral response (0.2s)	$S_{XS}$	1.535 g
Site modified spectral response (1.0s)	S <sub>X1</sub>	1.029 g
Long-period transition period (s)	TL	12 sec
	To	0.134 sec
	Ts	0.670 sec

	-
T	Sa
sec	g
0.0	0.614
0.134	1.535
0.670	1.535
0.70	1.469
0.80	1.286
0.90	1.143
1.00	1.029
1.1	0.935
2.0	0.514
3.0	0.343
4.0	0.257
6.0	0.171
8.0	0.129
10.0	0.103
12.0	0.086

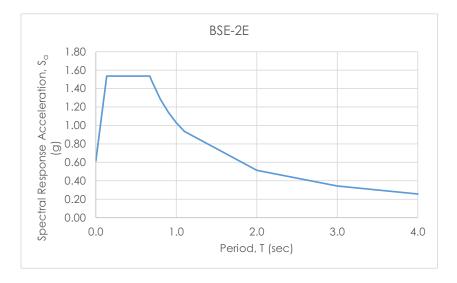

## Approximate Period of Structure

System // Reinforced Concrete Shear Wall

h <sub>n</sub>	194.00 ft
β	0.75 [All other framing systems]
Ct	0.02 [All other framing systems]
T	1.040 sec
Sa	0.989 g



and Building Enclosures

CLIENT UCSF

SUBJECT Tier 1 - Quick Checks - ACC Garage (Plaza and Below)

SHEET NO.	2	L
PROJECT NC		197042.00
DATE		11/04/2020
BY		KDP
CHECKED		KSM

W

89132

kip

Floor	Height (ft)	Columnø (in)	L <sub>girder</sub> (ft)	L <sub>retaining</sub> (ft)	Area (ft²)
Plaza	13.5	28	1107.7		48356
А	13	28	1190.2	713.42	56526
В	8.85	30	1272.7	713.42	56526
С	8.85	32	1272.7	713.42	56526
D	8.85	36	1272.7	713.42	56526
E	8.85	40	1115.3	713.42	47086
F	14.08	44			

	Unit: Ibs							Unit: kip
Floor	W <sub>beam</sub>	W <sub>girder</sub>	W <sub>slab</sub>	W <sub>column</sub>	W <sub>wall</sub>	W <sub>retaining</sub>	W <sub>other</sub>	W*
Plaza	3626663	1370738	3634584	271957	842700	1753666	725333	12567
А	4239431	1472832	4094161	237675	694830	3507331	847886	15402
В	4239431	1574925	4094161	222888	562860	2841179	847886	14662
С	4239431	1574925	4094161	268763	562860	2841179	847886	14708
D	4239431	1574925	4094161	335491	562860	2841179	847886	14775
E	3531431	1380226	3386161	542256	729280	3681227	706286	14273
F				356902	447850	1840613		2744

\* Includes weight calculated for walls and slabs within the core shown on different sheet

#### Masses

Reinforced concrete beams

	b	11.25 in	
	d	16 in	
	S	30 in	[spacing]
	Y	150 pcf	
Reinforced	l concrete girders		
	b	4.5 ft	
	d	22 in	
	Y	150 pcf	
Reinforced	l concrete slab		
	Y	150 pcf	
Reinforced	l concrete wall		
Reinforced	l concrete wall n	4	[number]



	Engineening of enectores
ļ	and Building Enclosures

CLIENT	UCSF

SUBJECT Tier 1 - Quick Checks - ACC Tower (Above Plaza)

	SHEET NO.		2	
	PROJECT NO	)		197042.00
-	DATE			11/04/2020
	BY			KDP
	CHECKED			KSM

W

45290

kip

Floor	Height (ft)	Columnø (in)	NS (ft)	EW(ff)	Area (ft²)
Roof	12.83	26	133.33	133.33	14969
8	13	26	166.00	169.33	25300
7	13	26	166.00	169.33	25300
6	13	28	166.00	169.33	25300
5	13	32	166.00	169.33	25300
4	13	32	166.00	169.33	25300
3	13	34	166.00	169.33	25300
2	13	34	166.00	169.33	25300
1	15	36	166.00	169.33	25300
Plaza	13.5	38			

	Unit: Ibs						Unit: kip
Floor	W <sub>beam</sub>	W <sub>girder</sub>	W <sub>slab</sub>	W <sub>column</sub>	W <sub>wall</sub>	W <sub>other</sub>	W*
Roof	966734	347750	654884	285743	821500	224532	3637
8	1633980	347750	1106890	287587	826800	379505	4920
7	1633980	347750	1106890	310560	826800	379505	4943
6	1633980	347750	1106890	384583	826800	379505	5017
5	1633980	347750	1106890	435634	826800	379505	5068
4	1633980	347750	1106890	463712	826800	379505	5096
3	1633980	347750	1106890	491790	826800	379505	5124
2	1633980	347750	1106890	563981	890400	379505	5274
1	1633980	347750	1106890	637056	906300	379505	5367
Plaza				318970	429300		843

\* Includes weight calculated for walls and slabs within the core shown on different sheet

[number]

#### Masses

Reinforced concrete beams

b	10 in	
d	15.5 in	
s	30 in	[spacing]
Ŷ	150 pcf	[0]0 00001[9]

Reinforced concrete girders [diagonal]

	* * * *	
n	4	[number]
L	53.5 ft	
b	5 ft	
d	26 in	
Y	150 pcf	

### Reinforced concrete slab

d	3.5 in
Y	150 pcf

#### Reinforced concrete wall

n	4
t	2 ft
L	53 ft
Y	150 pcf

Other weight (superimposed dead load) 15 psf



 SHEET NO.
 3

 PROJECT NO.
 197042.00

 DATE
 11/04/2020

 BY
 KDP

 CHECKED
 KSM

and Building Enclosures

SUBJECT Tier 1 - Quick Checks - ACC Building ELF

CLIENT UCSF

	[kip]	[f†]	[ft]	[kip-ft]		[kip]	[kip]
Floor	Wi	h <sub>i</sub>	(h <sub>i</sub> ) <sup>k</sup>	W <sub>i</sub> (h <sub>i</sub> ) <sup>k</sup>	C <sub>vi</sub>	Fi	Vi
Roof	3637	194.8	194.8	708637	0.068	9074	9074
8	4920	182.0	182.0	895357	0.086	11465	20539
7	4943	169.0	169.0	835280	0.080	10696	31235
6	5017	156.0	156.0	782567	0.075	10021	41256
5	5068	143.0	143.0	724646	0.070	9279	50535
4	5096	130.0	130.0	662411	0.064	8482	59017
3	5124	117.0	117.0	599446	0.058	7676	66693
2	5274	104.0	104.0	548415	0.053	7022	73716
1	5367	91.0	91.0	488268	0.047	6252	79968
Plaza	13410	76.0	76.0	1018930	0.098	13047	93015
А	15402	62.5	62.5	962395	0.093	12324	10533
В	14662	49.5	49.5	725545	0.070	9291	11462
С	14708	40.6	40.6	597646	0.058	7653	12228
D	14775	31.8	31.8	469599	0.045	6013	12829
E	14273	22.9	22.9	327322	0.032	4191	13248
F	2744	14.1	14.1	38651	0.004	495	13298
	134422			10385116	1.00	132982	

T 1.040 sec

k 1.00

W 134422 kip

С

- 1.0 [Modification factor, buildings 4 stories or greater]
- S<sub>a</sub> 0.989 g
- V 132982 kip

	SHEET NO.	4
SIMPSON GUMPERTZ & HEGER	PROJECT NO.	197042.00
Engineering of Structures     and Building Enclosures	DATE	11/04/2020
CLIENT UCSF	ВҮ	KDP
SUBJECT Tier 1 - Quick Checks - ACC Building Shear Stress Check	CHECKED	KSM

SHEAR STRESS CHECK: The shear stress in the concrete shear walls, calculated using the Quick Check procedure of Section 4.4.3.3, is less than the greater of 100 lb/in.<sup>2</sup> (0.69 MPa) or  $2\sqrt{f_c^2}$ .

	[kip]	[kip]
Floor	Vi	V <sub>i</sub> /M <sub>s</sub>
Roof	9074	2016
8	20539	4564
7	31235	6941
6	41256	9168
5	50535	11230
4	59017	13115
3	66693	14821
2	73716	16381
1	79968	17771
Plaza	93015	20670
А	105339	23409
В	114629	25473
С	122282	27174
D	128296	28510
Е	132487	29442
F	132982	29552

 $M_{s}$ 

N-S		E-W	
[in <sup>2</sup> ]	[psi]	[in <sup>2</sup> ]	[psi]
Aw	σ	Aw	σ
36896	54.7	SANS*	SANS
36896	123.7	SANS	SANS
36896	188.1	SANS	SANS
40352	227.2	SANS	SANS
48032	233.8	SANS	SANS
48032	273.0	SANS	SANS
52256	283.6	SANS	SANS
52256	313.5	SANS	SANS
56736	313.2	SANS	SANS
180864	114.3	188388	109.7
180864	129.4	188388	124.3
180864	140.8	188388	135.2
180864	150.2	188388	144.2
180864	157.6	188388	151.3
180864	162.8	188388	156.3
180864	163.4	188388	156.9
		* Same as l	N C

\* Same as N-S

l

4.5 ASCE 41-17 Table 4-8
--------------------------

f <sub>c</sub>	4000	psi	
√f <sub>c</sub>	63.2	psi	

Floor	σ/√f <sub>c</sub>	]
Roof	0.86	
8	1.96	
7	2.97	NG
6	3.59	NG
5	3.70	NG
4	4.32	NG
3	4.48	NG
2	4.96	NG
1	4.95	NG
Plaza	1.81	
А	2.05	NG
В	2.23	NG
С	2.38	NG
D	2.49	NG
E	2.57	NG
F	2.58	NG

0.43	r
	l
0.98	
1.49	I
1.80	I
1.85	ĺ
2.16	ĺ
2.24	ĺ
2.48	
2.48	
0.90	
1.02	
1.11	
1.19	l
1.25	l
1.29	ĺ
1.29	

DCR

SIMPSON GUMPERTZ & HEGER	SHEET NO	5 197042.00
Engineering of Structures     and Building Enclosures	DATE	11/04/2020
CLIENT UCSF	BY	CAO
SUBJECT Tier 1 - Quick Checks - ACC Garage Weight Inside Core	CHECKED	KDP

Floor	Height (ft)	Area (ft <sup>2</sup> )
Plaza	13.5	1585
А	13	1585
В	8.85	1585
С	8.85	1585
D	8.85	1585
E	8.85	1585
F	14.08	

Unit: Ibs  $\mathbf{W}_{\text{walls}}$ W<sub>corewall</sub> Floor  $\mathbf{W}_{\mathrm{slab}}$  $\mathbf{W}_{\mathrm{other}}$ Plaza А В С D Е F

7 in

Unit: kip	
w	
341	
308	
279	
279	
279	
316	
99	

**W** 1902 kip

Masses

Reinforced concrete slab d

Y 150 pcf

Reinforced	concrete wall

ed concrete w	an
n	4
t	2 ft
L	53 ft
Y	0 pcf

Other weight (superimposed dead load)

Openings Areas


2

(ft²) Wall L

(ft <sup>2</sup> )	_	N-S
$A_{slab}$		(in)
94		Thickness
118		6
10		8
116		
71		E-W
19		(in)
116		Thickness
94		6
94 109		6 8



(f†)

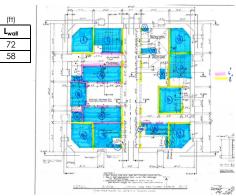

10 psf

[number]

Wall Length		
N-S		
(in)		
	Thickness	
	6	
	8	

SIMPSON GUMPERTZ & HEGER	SHEET NO PROJECT NO.	5 197042.00
Engineering of Structures     and Building Enclosures	DATE	11/04/2020
CLIENT	BY	CAO
SUBJECT Tier 1 - Quick Checks - ACC Tower Weight Inside Core	CHECKED	KDP

Floor	Height (ft)	Area (ft²)
Roof	12.83	1585
8	13	1585
7	13	1585
6	13	1585
5	13	1585
4	13	1585
3	13	1585
2	13	1585
1	15	1585
Plaza	13.5	

	Unit: Ibs			
Floor	W <sub>slab</sub>	W <sub>corewall</sub>	W <sub>walls</sub>	Wother
Roof	138665	0	181801	15847
8	138665	0	182974	15847
7	138665	0	182974	15847
6	138665	0	182974	15847
5	138665	0	182974	15847
4	138665	0	182974	15847
3	138665	0	182974	15847
2	138665	0	197049	15847
1	138665	0	200567	15847
Plaza		0	95006	

Unit: kip			
	w		
	336		
	337		
	337		
	337		
	337		
	337		
	337		
	352		
	355		
	95		

**W** 3163 kip

Masses

Reinforced concrete slab and walls within core (excluding core shear walls)

7 in

150 pcf

Reinforced concrete corewall

d

Y

n	4	[number]
t	2 ft	
L	53 ft	
Y	0 pcf	

Other weight (superimposed dead load) 10 psf

(ft<sup>2</sup>)

 $\mathbf{A}_{\text{slab}}$ 

Openings

Areas

Wall Length

N-S	
(in)	(f†)
Thickness	L <sub>wall</sub>
6	17
8	128

